




As built		05.06.2015		K.H.	
Arbeidstegning		16.05.2014		K.H.	
Vannkanten P					
SIGN: K.H.		DATO: 13.09.2012			
GODKJENT:		DATO:			
00U B5			MALESTOKK: 1:50	FILNAVN: Vann8010	REV. A
A1			TEGN.NR.: V28-B5-001		
			ERSTATNING FOR:	ERSTATTET AV:	
HENVISNING:		BEREGNING:		INFO:	

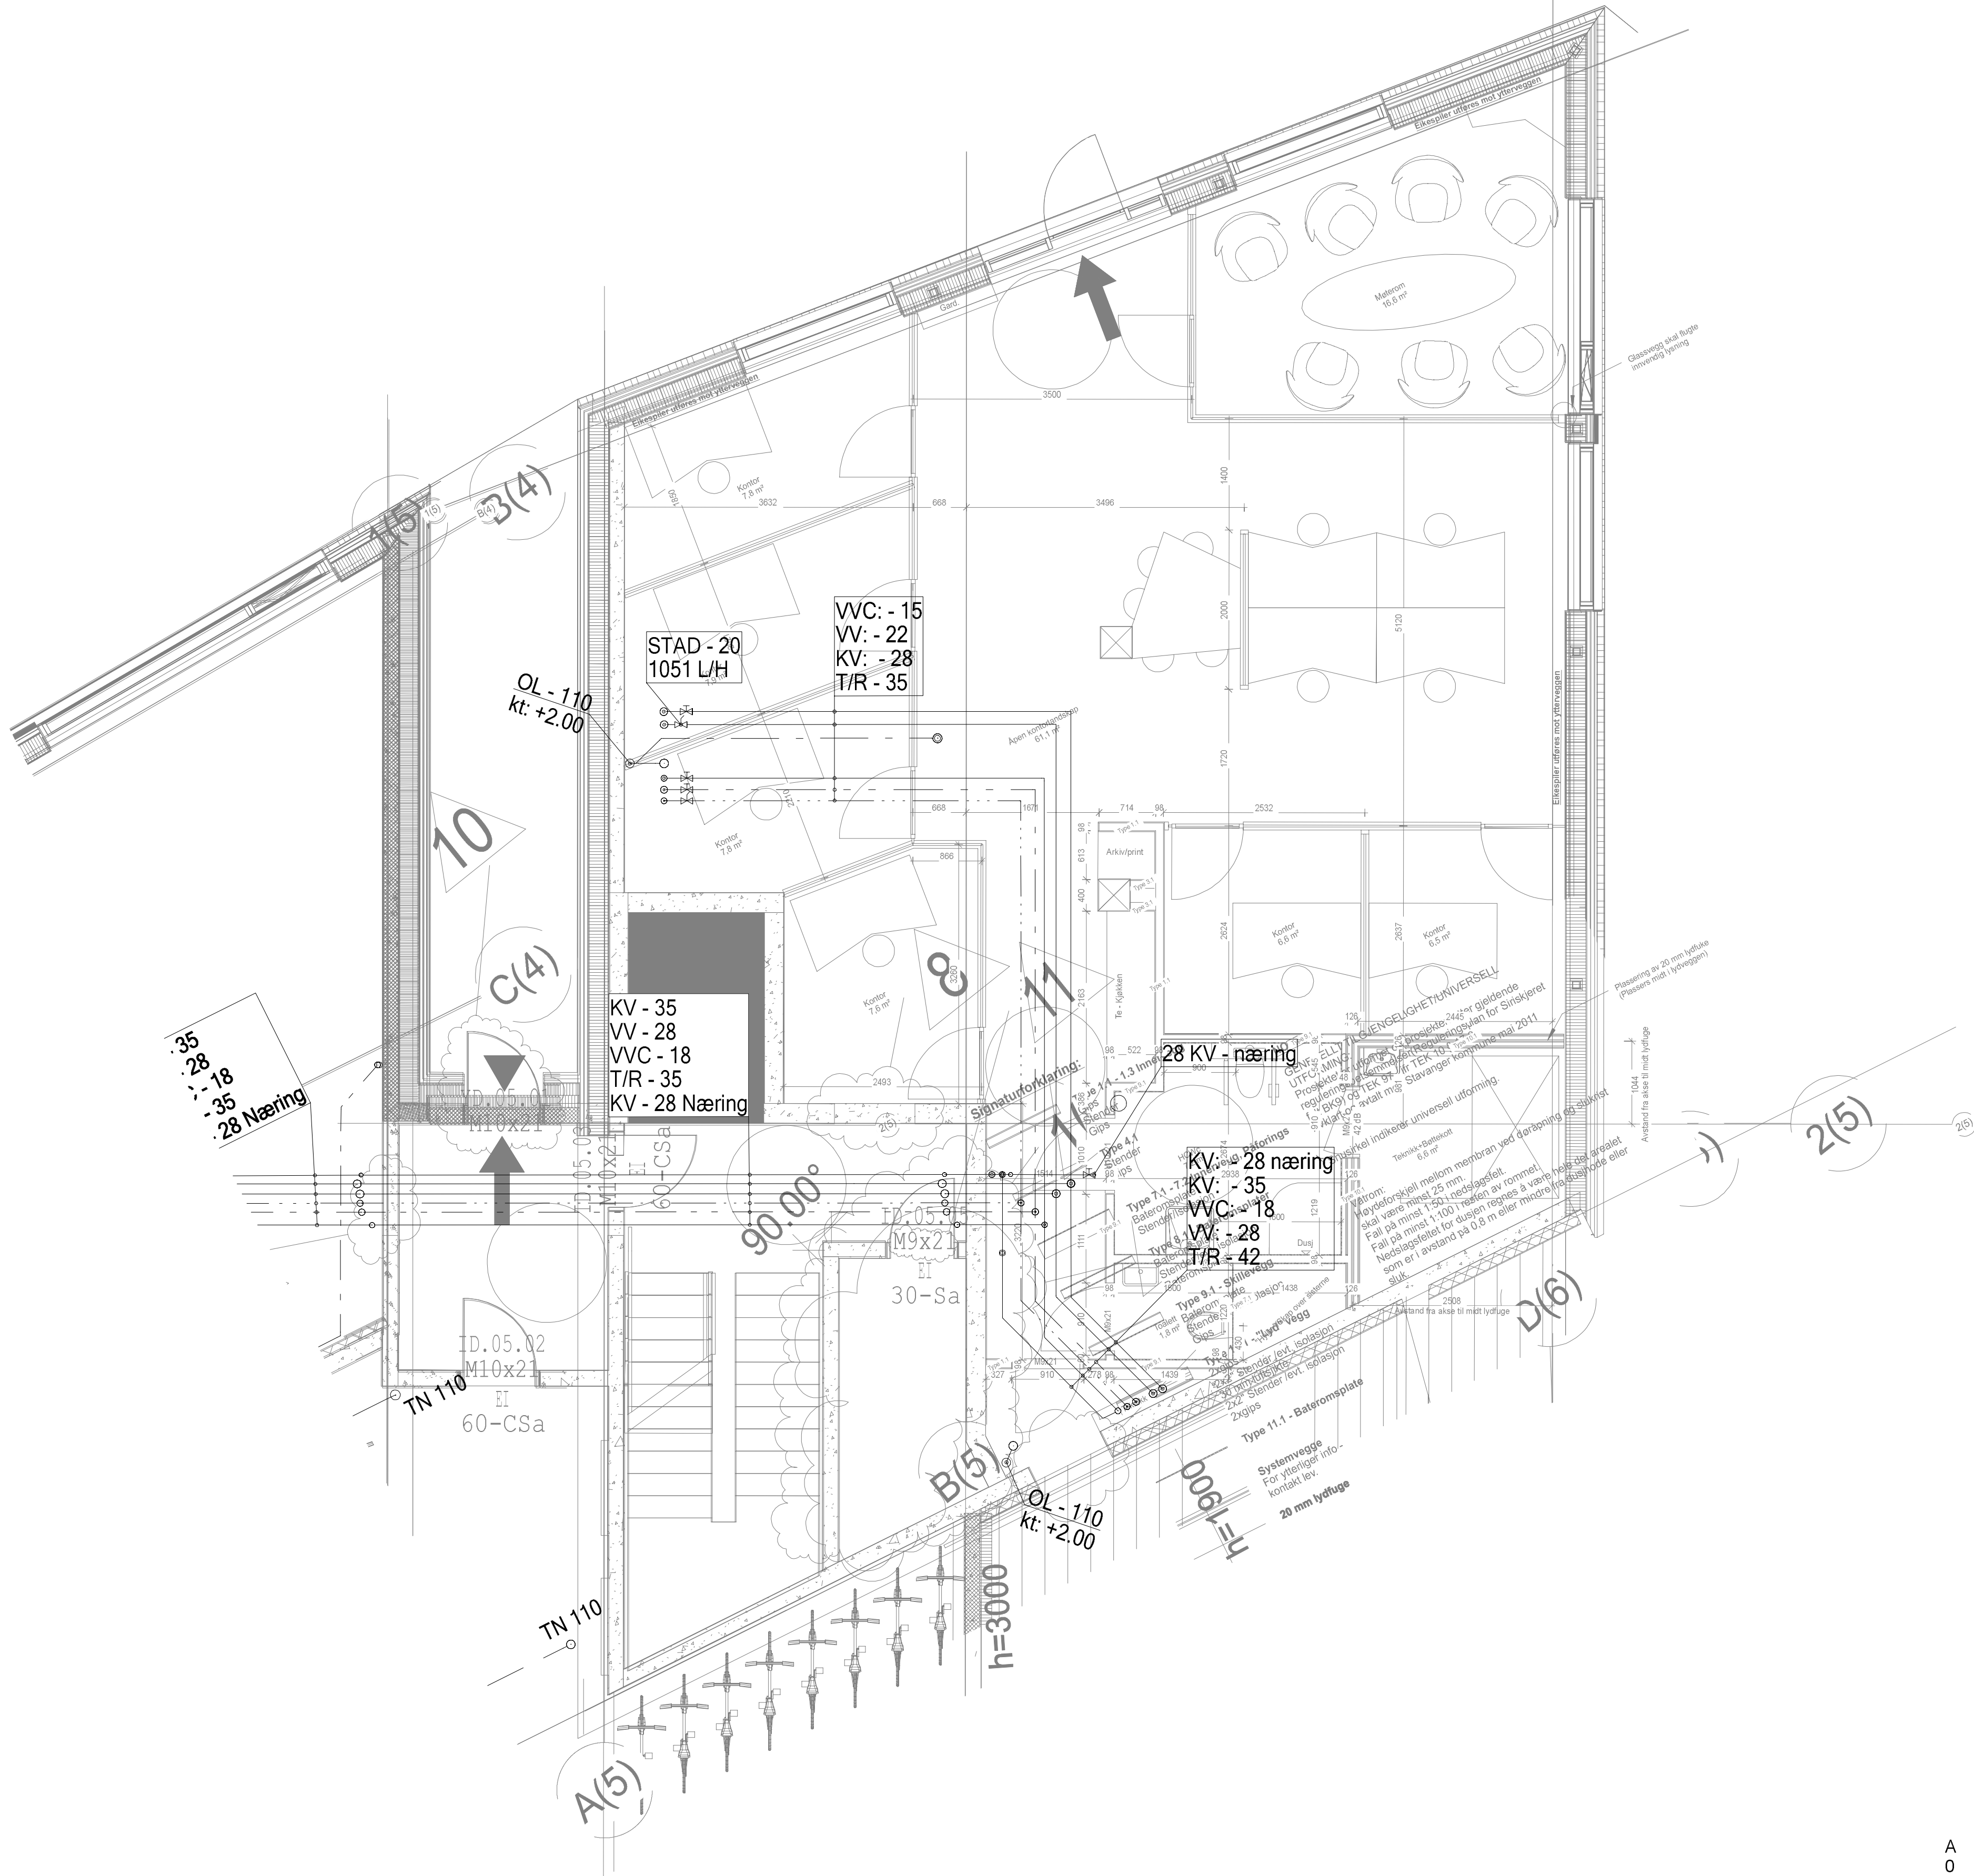